
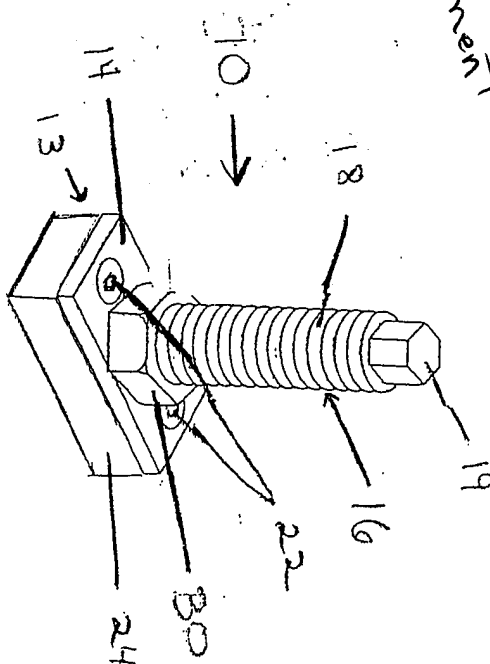


DRAWING AMENDMENTS

Please amend FIGURE 2 as shown in the "Annotated Marked-Up Drawing" attached hereto as Exhibit A, and in "Replacement Sheet No.1" of the drawings attached hereto as Exhibit B.

01P/11/04
MAY 28 2004
PATENT & TRADEMARK OFFICE

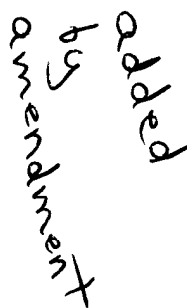

76H7

REPLACEMENT SHEET 1

EXHIBIT B

